
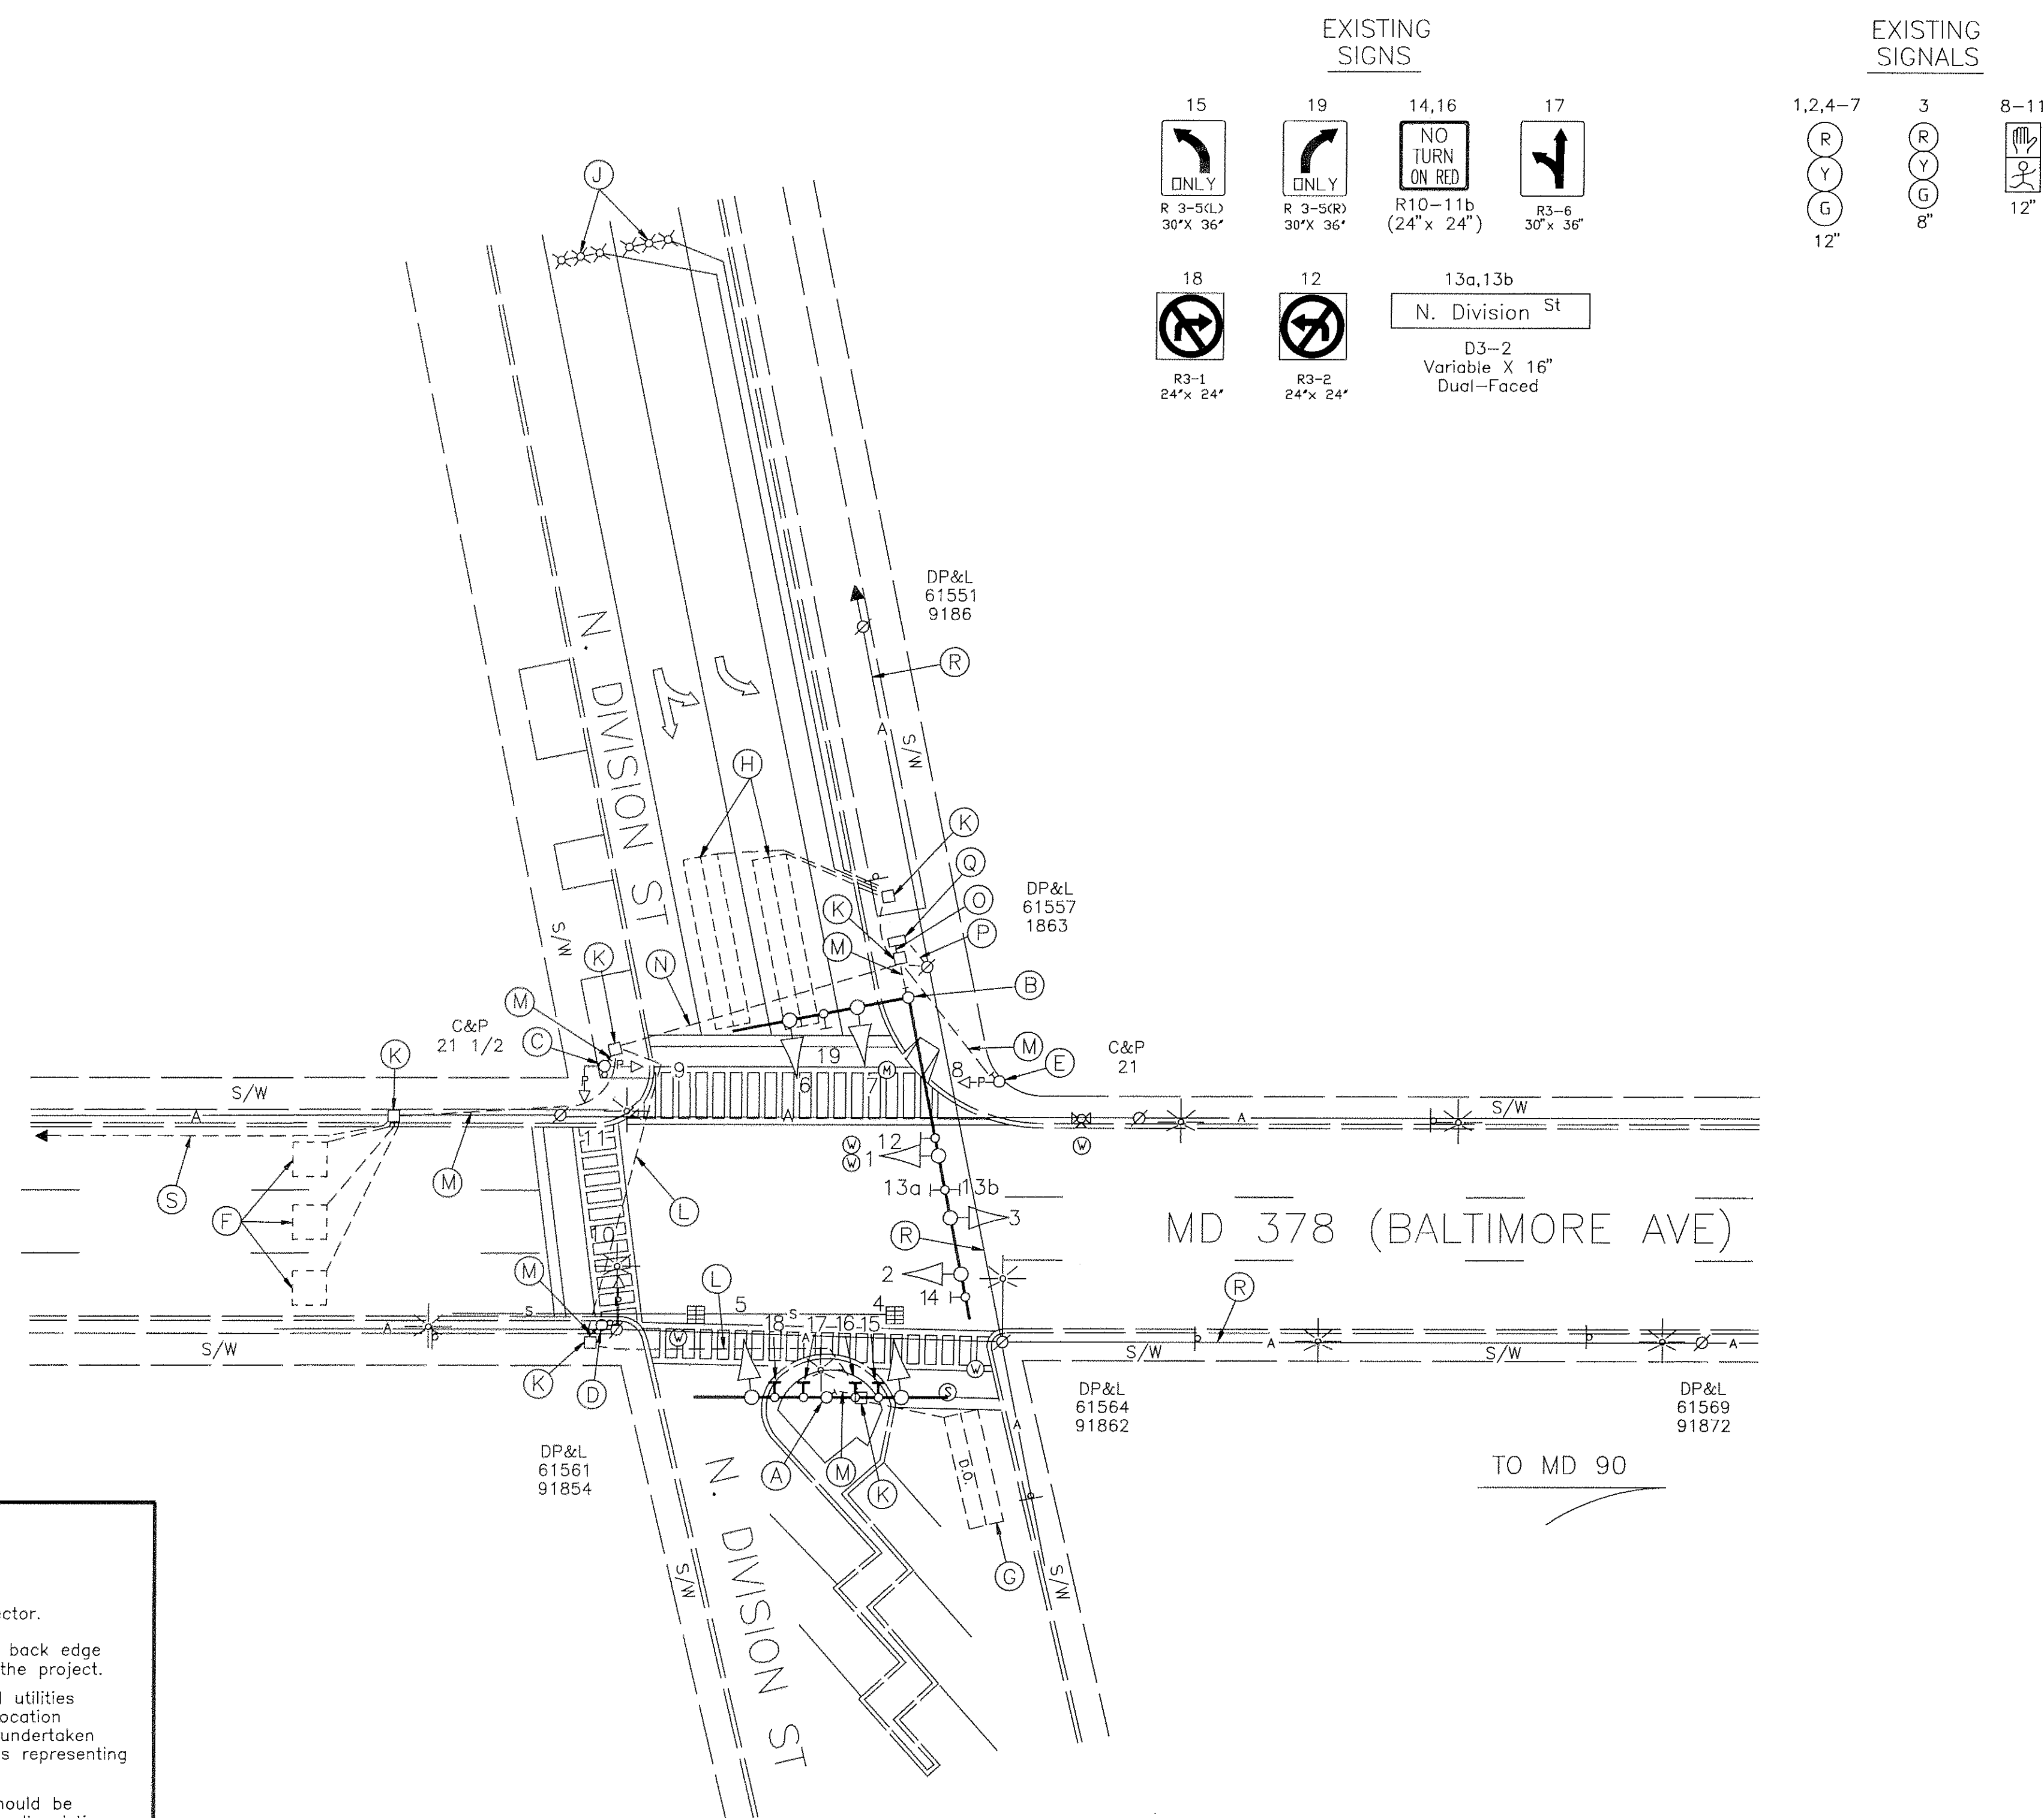


F H W A	STATE	FED. AID PROJ. NO.	SHEET NO.	TOTAL SHEETS
REGION NO.				
3	MD			

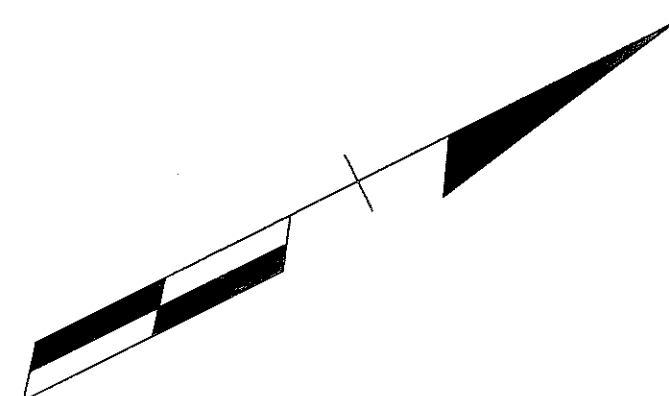

- GENERAL NOTES:

1. "D.O." indicates a delay-output loop detector.
2. The Right-Of-Way Line is located at the back edge of the sidewalk throughout the limits of the project.
3. This plan reflects only those underground utilities that were apparent at the time of this location being asbuilt. A detailed review was not undertaken and this plan should not be construed as representing all underground utilities in the area.
4. Any modification to this subject signal should be preceded by a thorough identification of all existing utilities.


GEOMETRIC LEGEND

PROPOSED _____


EXISTING _____

LEGEND OF UNDERGROUND
AND OVERHEAD UTILITIES

AERIAL CABLE	— A — A —
ELECTRIC	— E — E —
TELEPHONE	— T — T —
GAS	— G — G —
SEWER	— S — S —
WATER	— W — W —
CABLE TV	— TV — TV —

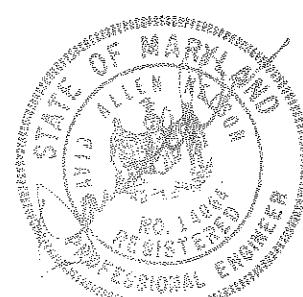

AS-BUILT PREPARED BY:

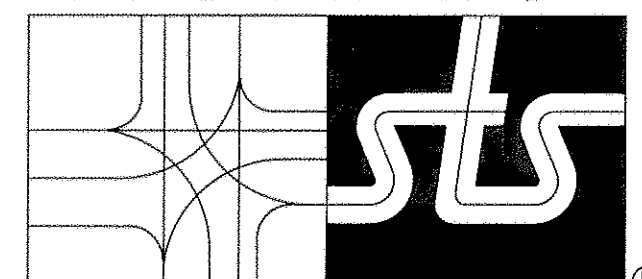

STREET TRAFFIC STUDIES, LTD
Gateway International
 1302 Concourse Drive, Suite 104
 Linthicum, Maryland 21090
 (410) 859-3553

REVISIONS					
(A)	1-25-95				
	ASBUILT				
	S.H.A. NO:	855-25056011			
P.P.	Z				

APPROVALS

CHIEF, SIGNAL DESIGN SECTION

ASST. DISTRICT ENGINEER, TRAFFIC

CHIEF, TRAFFIC ENGINEERING DESIGN DIVISION

DIRECTOR, OFFICE OF TRAFFIC AND SAFETY

MDOT – STATE HIGHWAY ADMINISTRATION
Office of Traffic and Safety
TRAFFIC ENGINEERING DESIGN DIVISION

DRAWN BY:	C. F. STARKEY
DES. BY:	R. R. ZACHERL
CHK. BY:	

MD 378 (BALTIMORE AVENUE) AND N. DIVISION STREET
OCEAN CITY COUNTY WORCESTER

DATE: 9-22-94 F.A.P. NO. _____
SCALE: 1"=20' S.H.A. NO. 855-25056011